

LEGEND

ASBUILT

1. A3 SCALE DRAWING.
2. ALL DIMENSIONS ARE TO BE CHECKED ON SITE PRIOR TO ALL CONSTRUCTION OR COMPONENT MANUFACTURING.
3. THIS DRAWING IS TO BE READ IN CONJUNCTION WITH A RELEVANT ARCHITECT, STRUCTURAL SERVICES ENGINEERS AND SPECIALIST CONTRACTORS SPECIFICATION AND DRAWINGS.
4. ALL DIMENSIONS ARE IN MILLIMETRES UNLESS OTHERWISE STATED.

PROJECT:
STUDIO FIT-OUT


LOCATION:
STUDIO (G01), Ground Floor,
BS-01, DSC, DUBAI
UAE.

CLIENT:
ATLAS TELEVISION FZ LLC

CONTRACTOR:
 **AUJAN INTERIOR DECORATION LLC.**
P.O BOX: 98261, Dubai, Uae.
Tel:- 042637936, Fax:-042637934
Email:- aujaninteriors@gmail.com

DRAWING TITLE:
PROPOSED PARTITION LAYOUT

DRAWING NO: 04	SCALE: cm
DATE: 07/05/2018	REV: 1
DRAWN BY: JOHN	CHECKED BY:

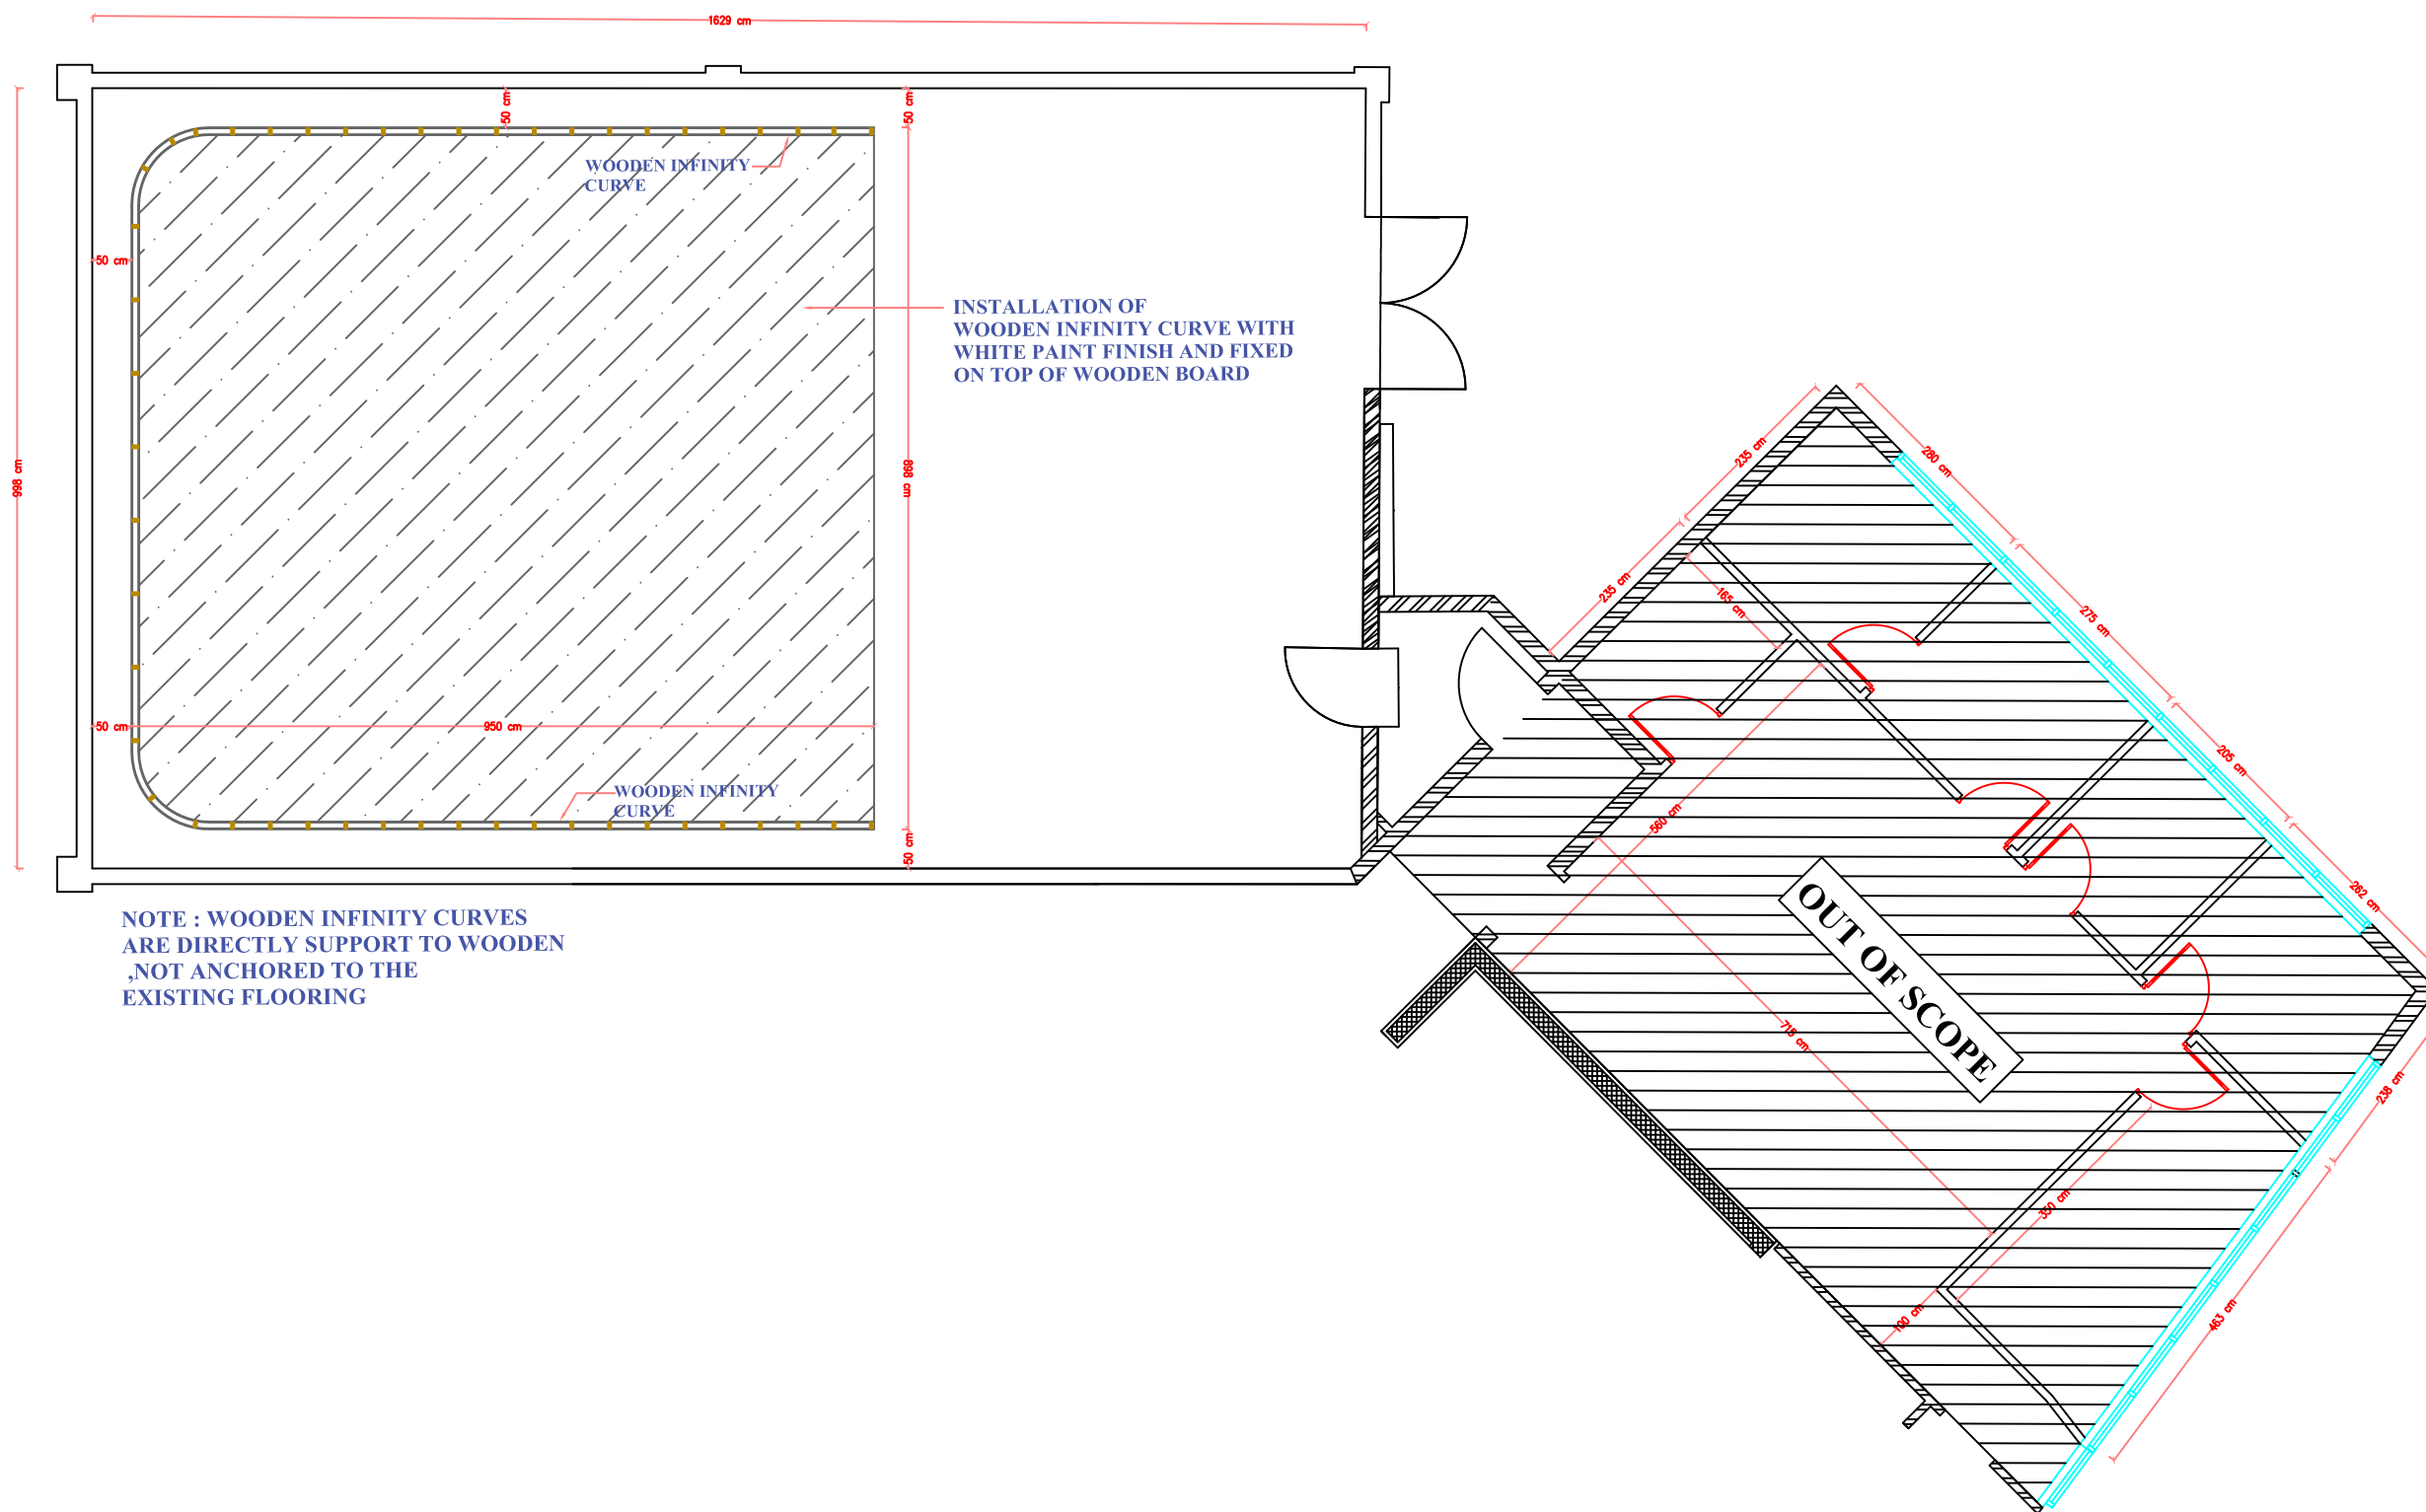

PROPOSED PARTITION LAYOUT