



SECTION A/A

NOTE : WOODEN INFINITY CURVES ARE DIRECTLY SUPPORT TO WOODEN ,NOT ANCHORED TO THE EXISTING FLOORING

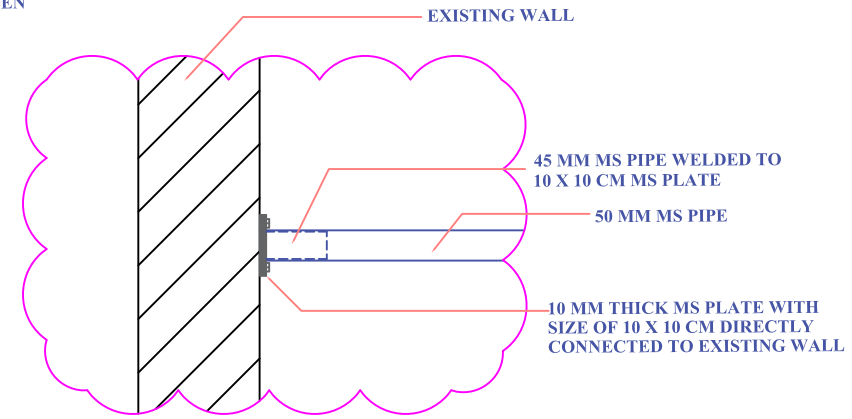

DETAIL - A

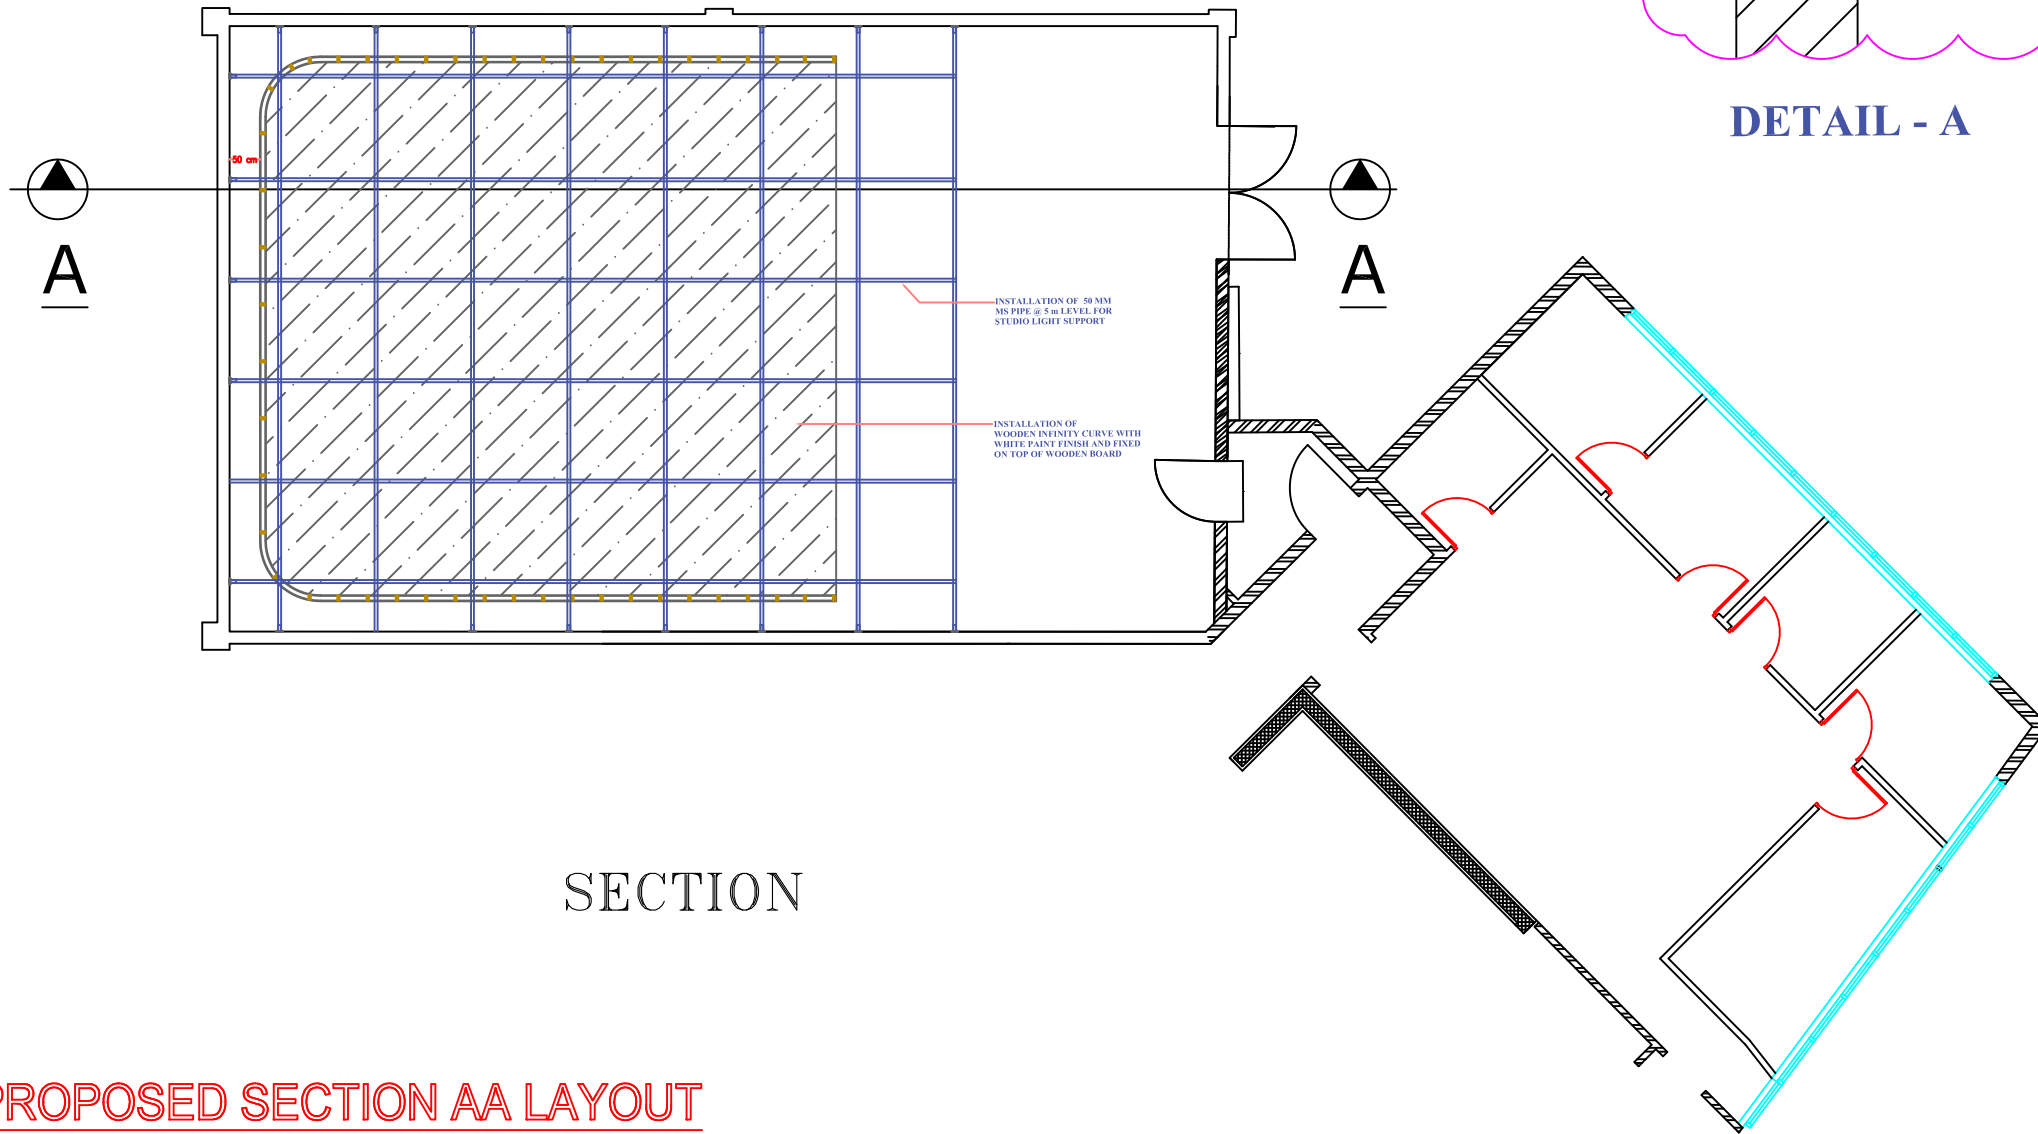

SECTION

PROPOSED SECTION AA LAYOUT

ASBUILT

LEGEND

	60x60 DIFFUSER LIGHT
	Emergency Light
	Smoke Detector (Low Level)
	Supply Air Diffuser
	Return Air Diffuser
	DOWN LIGHT

1. A3 SCALE DRAWING.
2. ALL DIMENSIONS ARE TO BE CHECKED ON SITE PRIOR TO ALL CONSTRUCTION OR COMPONENT MANUFACTURING.
3. THIS DRAWING IS TO BE READ IN CONJUNCTION WITH A RELEVANT ARCHITECT, STRUCTURAL SERVICES ENGINEERS, SPECIALIST CONTRACTORS, SPECIFICATION AND DRAWINGS.
4. ALL DIMENSIONS ARE IN MILLIMETRES UNLESS OTHERWISE STATED.

PROJECT:

STUDIO FIT-OUT

LOCATION:

STUDIO (G01), Ground Floor, BS-01,DSC,DUBAI UAE.

CLIENT:

ATLAS TELEVISION FZ LLC

CONTRACTOR:



AUJAN INTERIOR DECORATION LLC.
P.O BOX: 98261, Dubai, Uae.
Tel:- 042637936, Fax:-042637934
Email:- aujaninteriors@gmail.com

DRAWING TITLE:

PROPOSED SECTION AA LAYOUT

DRAWING NO: 09 SCALE: cm

DATE: 07/05/2018 REV: 1

DRAWN BY: JOHN CHECKED BY: